

May 8, 2014

**RE:**  
**ADDENDUM NO.2**  
**FOR BID NO: 2013-14-08**  
**“DETENTION POND AND RECONSTRUCTION OF**  
**SUGARCANE DRIVE FROM MILE 6 WEST TO MILE**  
**5 ½ WEST”**

Dear Bidders:

Attached you will find **ADDENDUM NO. 2, PAGE 1 OF 2** in connection with “**CITY OF WESLACO**” - request for bids for “**DETENTION POND AND RECONSTRUCTION OF SUGARCANE DRIVE FROM MILE 6 WEST TO MILE 5 ½ WEST**”.

Please add this **ADDENDUM NO. 2** to your bid packet so as to permit your company to submit a complete bid. See original bid packet **LEGAL NOTICE** page 3 paragraph 9.

If you do not receive all pages of **ADDENDUM NO. 2** please notify us immediately at (956) 447-2240.

Please be advised that this **ADDENDUM NO. 2** will complete your bid packet for “**DETENTION POND AND RECONSTRUCTION OF SUGARCANE DRIVE FROM MILE 6 WEST TO MILE 5 ½ WEST**”.

Thank you for your prompt attention to this matter.

**BY:**

---

**ADDENDUM NO. 1**  
**ACKNOWLEDGMENT OF RECEIPT**

# **ADDENDUM NO. 2**

**May 8, 2014**

**“DETENTION POND AND RECONSTRUCTION OF SUGARCANE DRIVE FROM MILE 6 WEST TO MILE 5 ½ WEST”**

**BID NO: 2013-14-08**

**Bid Opening Date: May 9, 2014**

## **PLEASE NOTE CHANGES AS FOLLOWS:**

### **No. 1 REVISED TITLE SHEET (includes signatures from City of Weslaco)**

- Updated U&D Sheets depicting the proposed waterline adjustment.


I, \_\_\_\_\_, acknowledge receipt of ADDENDUM NO.21 dated, May 8, 2014, for DETENTION POND AND RECONSTRUCTION OF SUGARCANE DRIVE FROM MILE 6 WEST TO MILE 5 ½ WEST.

\_\_\_\_\_  
Printed Bidder Name

\_\_\_\_\_  
Date

**NOTE: PLEASE SUBMIT THIS ADDENDUM WITH YOUR BID PACKET, IN ORDER TO COMPLETE THE BID.....**

User Name: ROBERT  
File Name: \$FILENAME\$.DWG  
Date and Time Plotted: 5/8/2014 10:39:47 AM

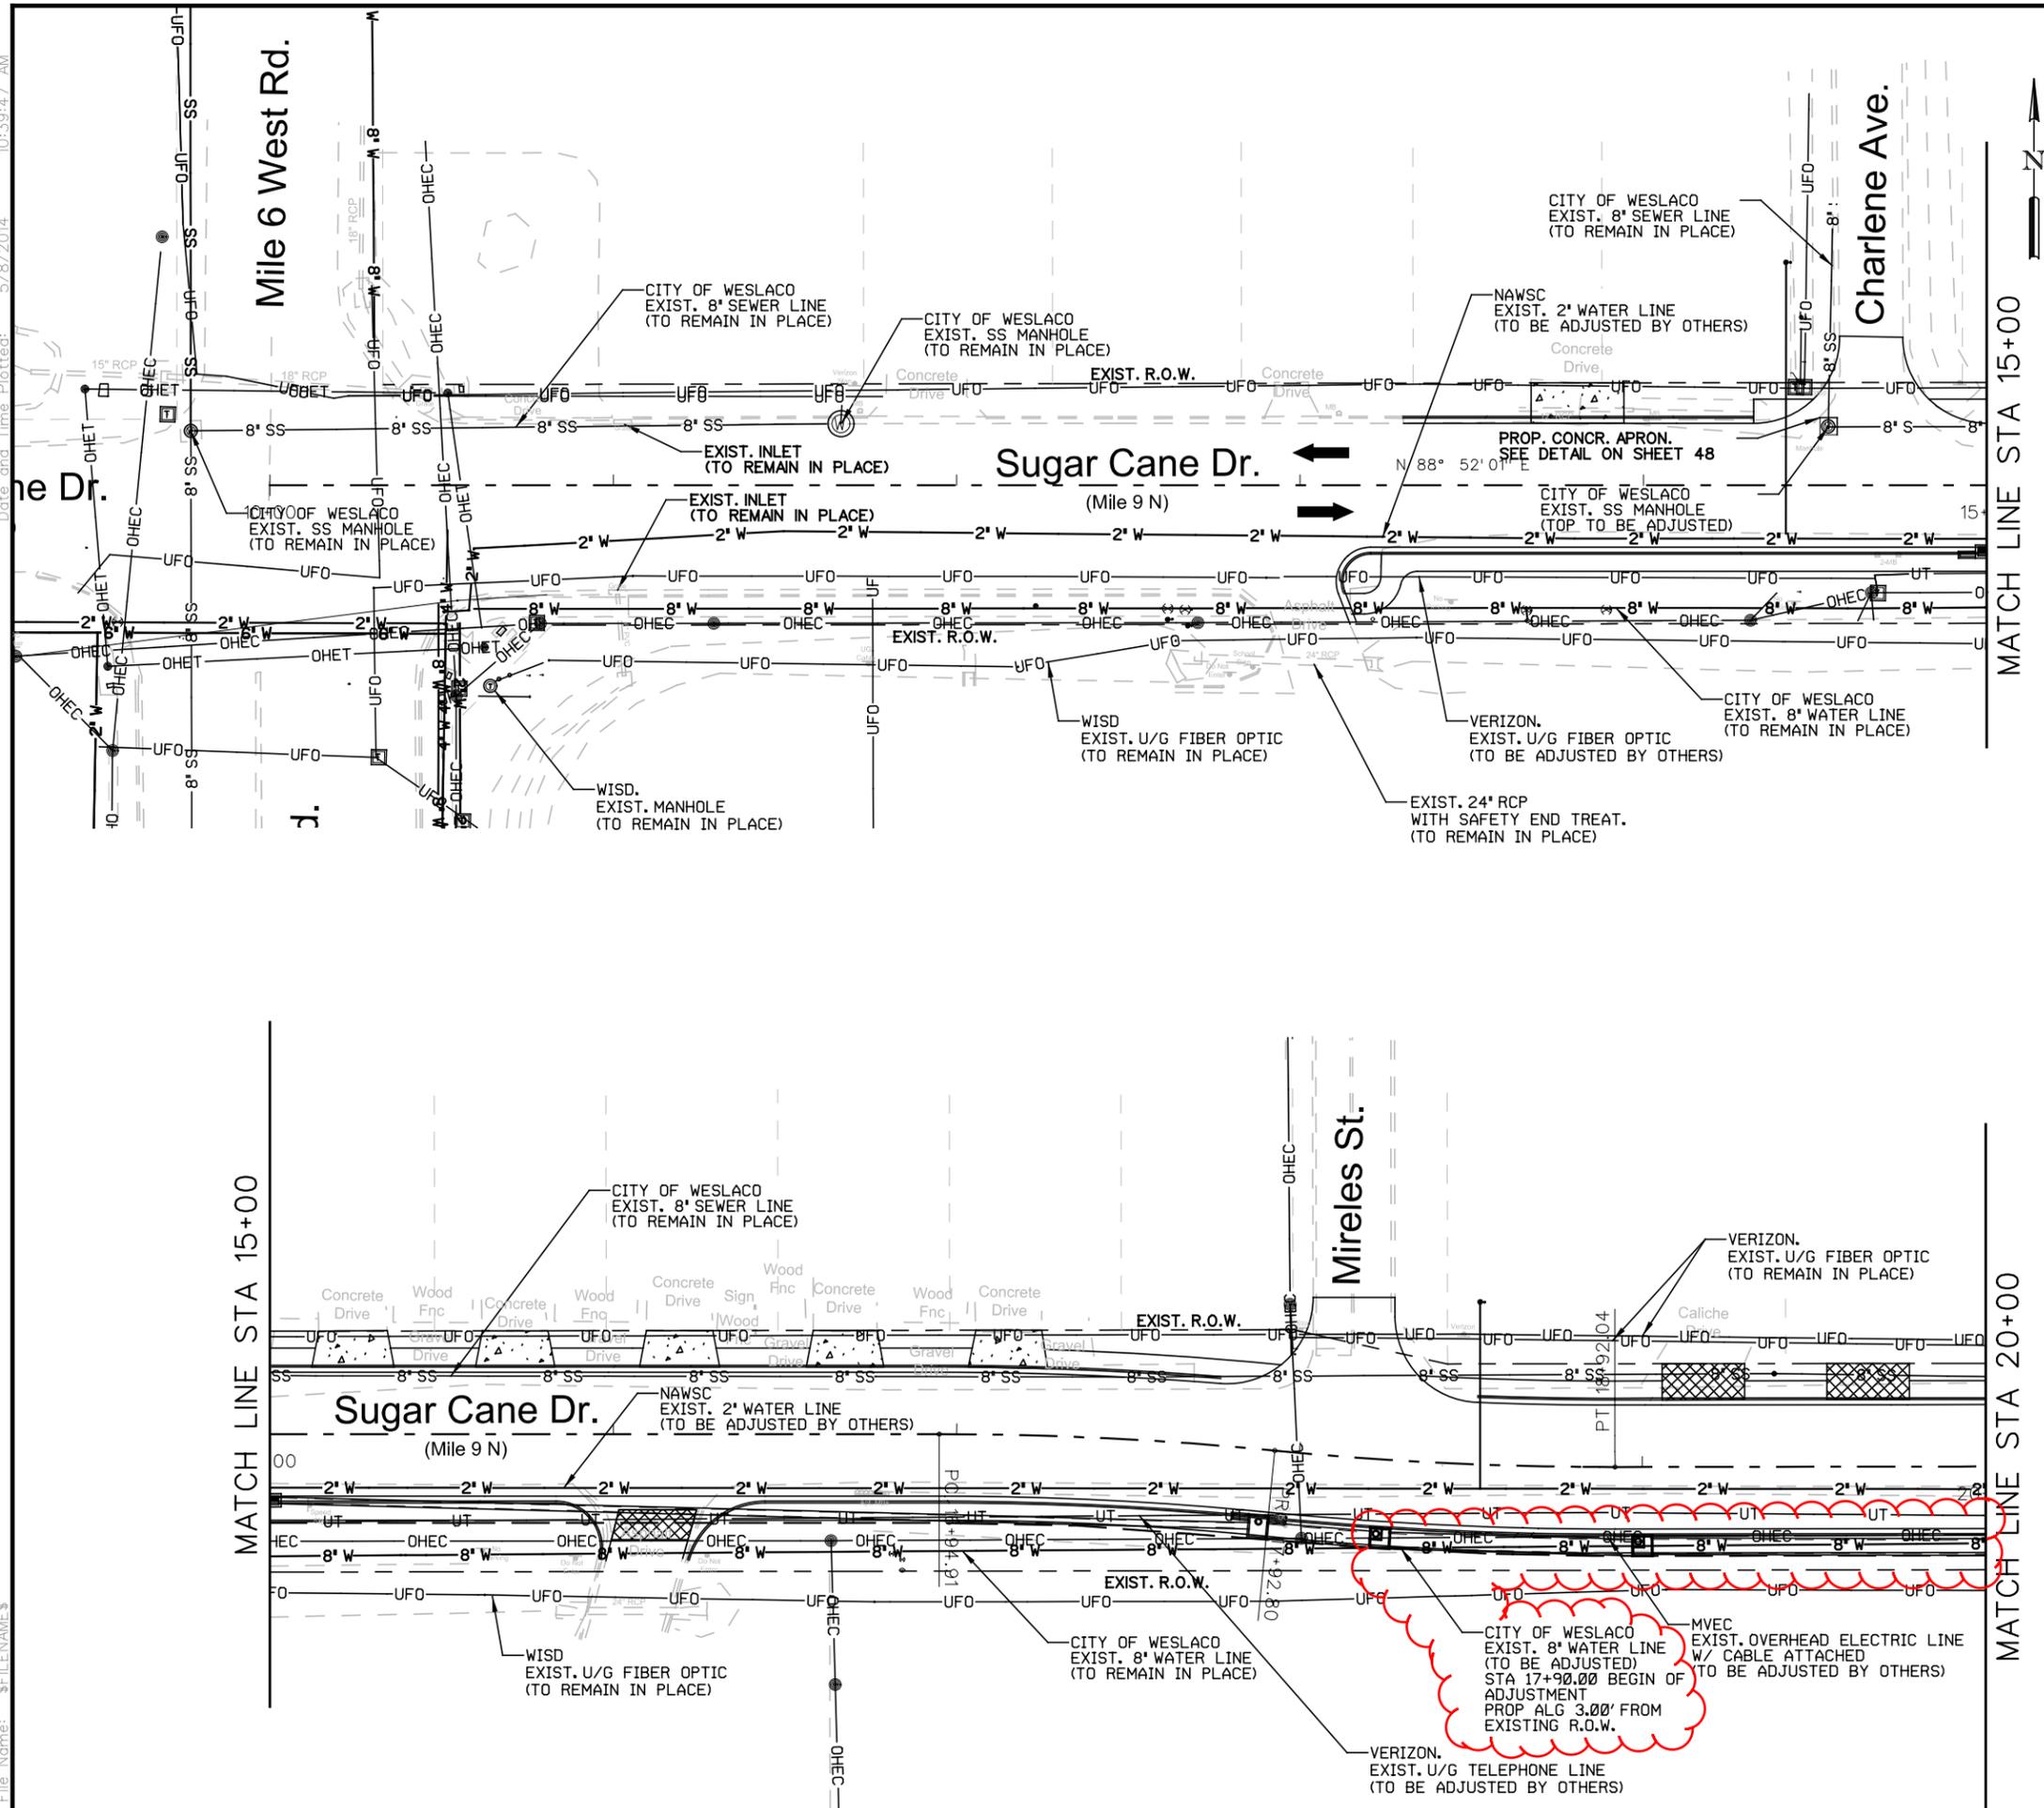

- LEGEND:**
- # W — EXIST. • (DIAM INCH) WATER LINE
  - # FM — EXIST. • (DIAM INCH) FORCE MAIN SANITARY SEWER LINE
  - # SS — EXIST. • (DIAM INCH) SANITARY SEWER LINE
  - # G — EXIST. • (DIAM INCH) GAS PIPELINE
  - UFO — EXIST. UNDERGROUND FIBER OPTIC CABLE
  - UT — EXIST. UNDERGROUND CABLE/TELE LINE
  - OHE — EXIST. OVERHEAD ELECTRIC LINE
  - HVTL — EXIST. HIGH VOLTAGE TRANSMISSION LINE
  - UE — EXIST. UNDERGROUND ELECTRIC LINE
  - OHEC — EXIST. OVERHEAD ELECTRIC LINE WITH CABLE LINE ATTACHED
  - OHEFC — EXIST. OVERHEAD ELECTRIC LINE WITH FIBER OPTIC AND CABLE LINE ATTACHED
  - (W) — EXISTING SANITARY SEWER MANHOLE
  - (T) — EXISTING TEL/CABLE PED.
  - — DIRECTION OF FLOW
  - ➔ — OUTFALL CHANNEL FLOW

NO.	DATE	REVISION	APP.



*Mark Corbitt*  
MARK D. CORBITT DATE 5/8/2014




**TEDSI INFRASTRUCTURE GROUP**  
Consulting Engineers  
1201 E. Expressway 83  
Mission, Texas 78572  
(956) 424-7898  
TBPE F-1640


SUGARCANE RD  
**UTILITY & DRAINAGE LAYOUT**  
STA 10+00.00 TO STA 20+00.00

SCALE : 1"=50' SHEET 1 OF 3

FED. RD. DIV. NO.	FEDERAL AID PROJECT NO.	SHEET NO.
		44
STATE	DIST.	COUNTY
TEXAS		HIDALGO
CONT.	SECT.	JOB
		HIGHWAY NO.
		SUGAR CANE DR.

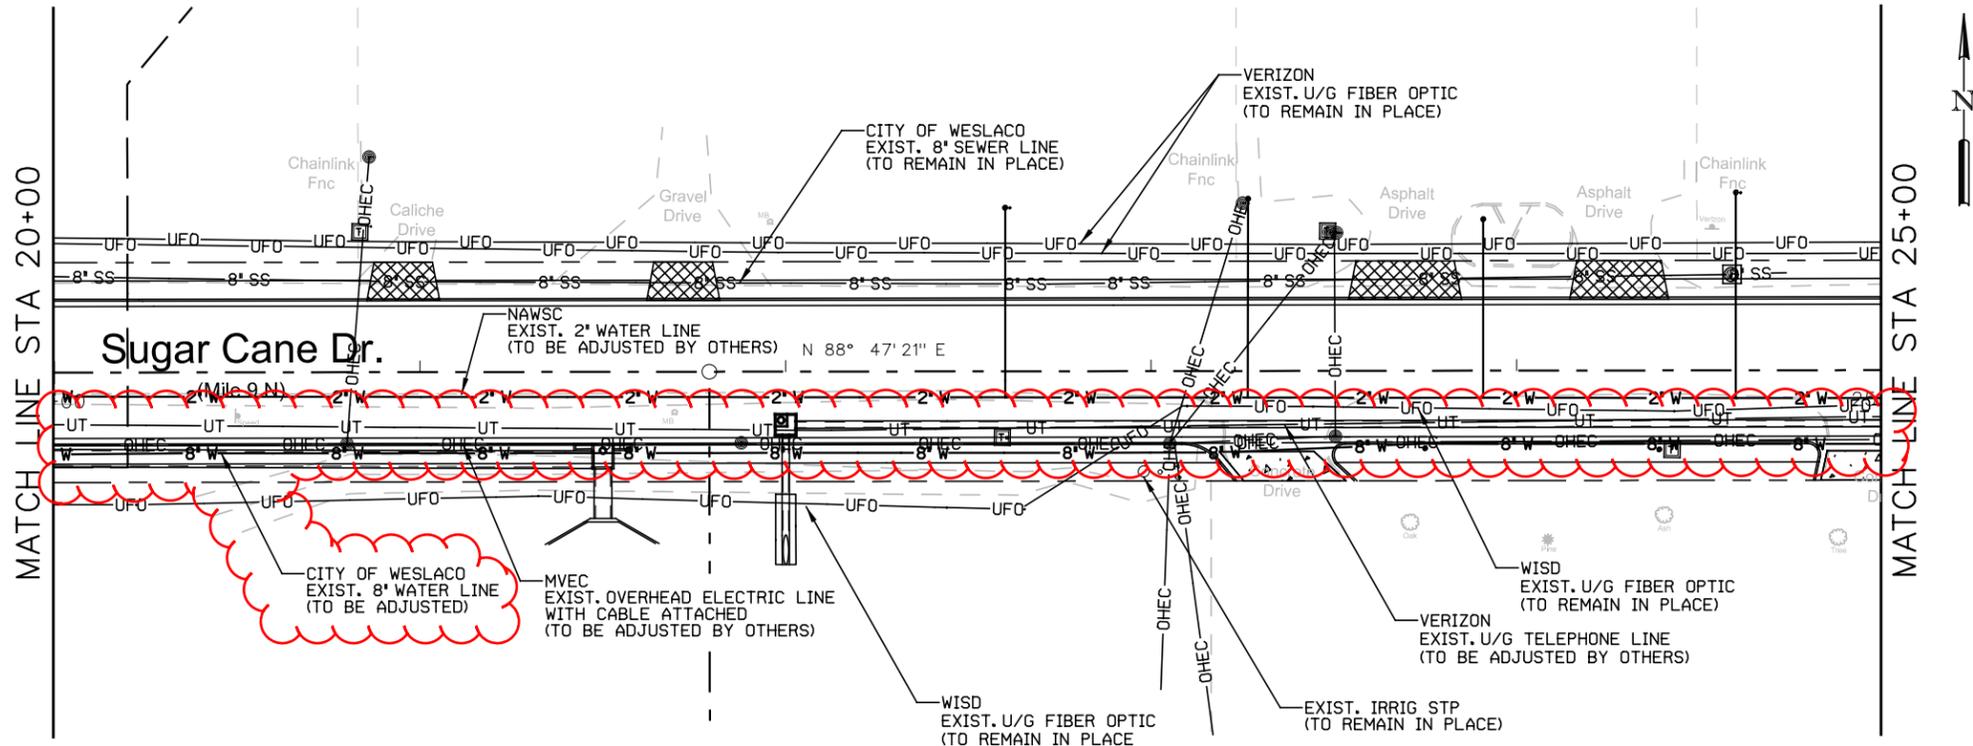

**!! CAUTION !!**  
EXISTING WESLACO INDEPENDENT SCHOOL DISTRICT UNDERGROUND FIBER OPTIC LINE  
THE CONTRACTOR WILL CONTACT MR. JEFFREY HARRIS (WISD) AT 956-969-6545 PRIOR TO WORKING IN THIS AREA

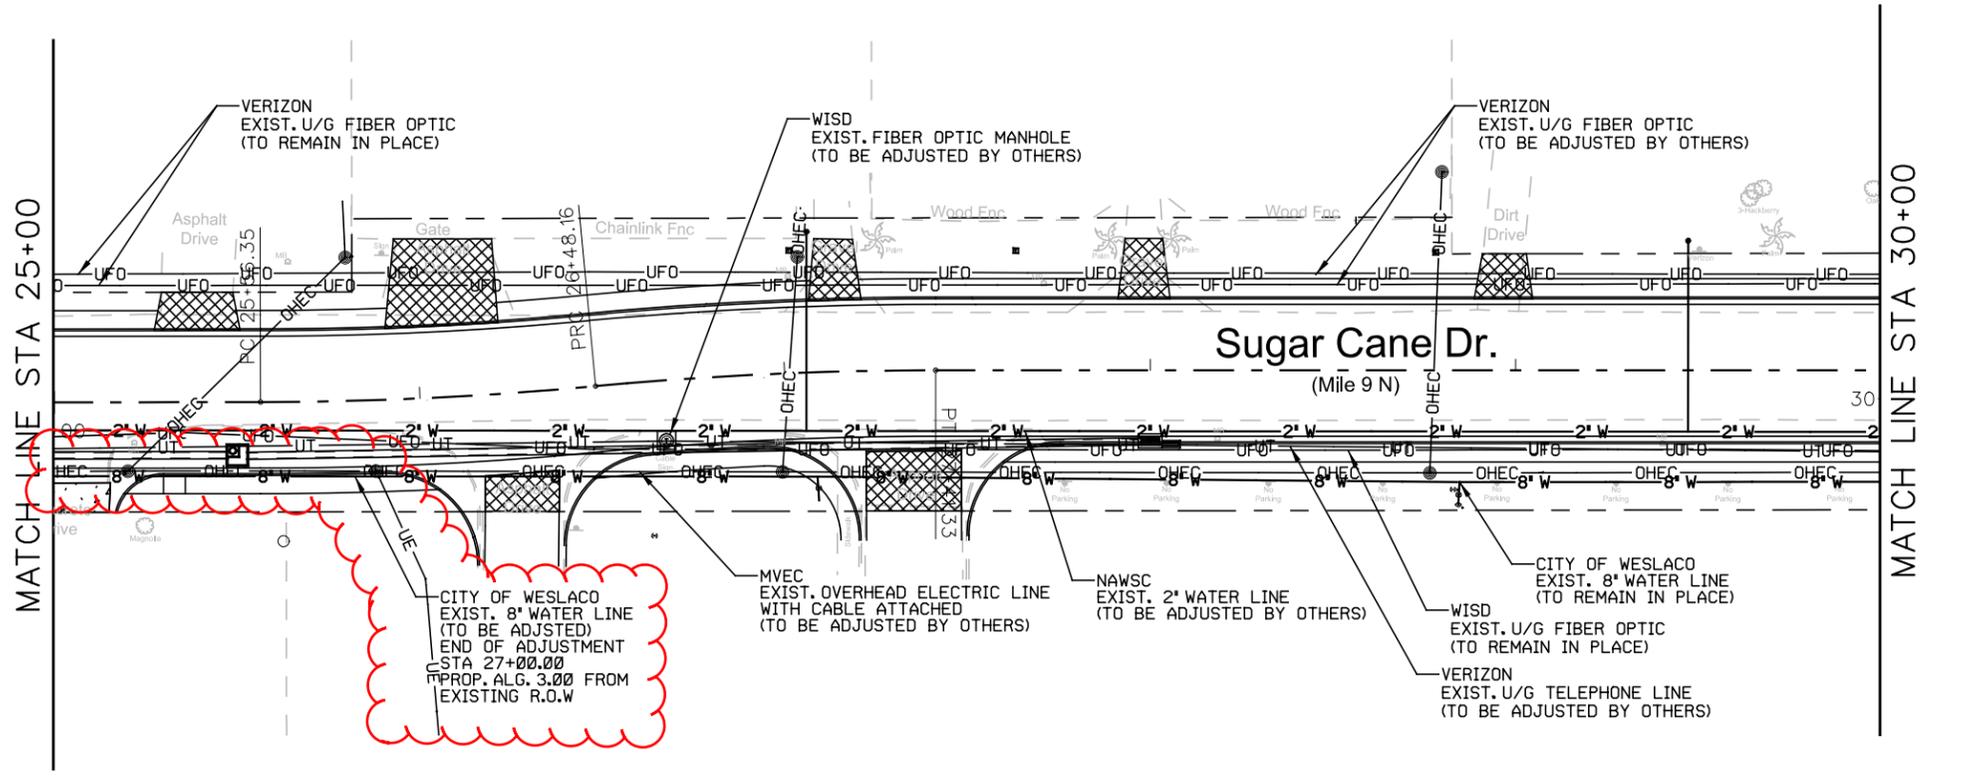

- LEGEND:**
- # W — EXIST. • (DIAM INCH) WATER LINE
  - # FM — EXIST. • (DIAM INCH) FORCE MAIN SANITARY SEWER LINE
  - # SS — EXIST. • (DIAM INCH) SANITARY SEWER LINE
  - # G — EXIST. • (DIAM INCH) GAS PIPELINE
  - UFO — EXIST. UNDERGROUND FIBER OPTIC CABLE
  - UT — EXIST. UNDERGROUND CABLE/TELE LINE
  - OHE — EXIST. OVERHEAD ELECTRIC LINE
  - HVTL — EXIST. HIGH VOLTAGE TRANSMISSION LINE
  - UE — EXIST. UNDERGROUND ELECTRIC LINE
  - OHEC — EXIST. OVERHEAD ELECTRIC LINE WITH CABLE LINE ATTACHED
  - OHEFC — EXIST. OVERHEAD ELECTRIC LINE WITH FIBER OPTIC AND CABLE LINE ATTACHED
  - (W) — EXISTING SANITARY SEWER MANHOLE
  - (F) — EXISTING TEL/CABLE PED.
  - — DIRECTION OF FLOW
  - — OUTFALL CHANNEL FLOW

NO.	DATE	REVISION	APP.



*Mark Corbitt*  
MARK D. CORBITT DATE 5/8/2014



**TEDSI INFRASTRUCTURE GROUP**  
Consulting Engineers  
1201 E. Expressway 83  
Mission, Texas 78572  
(956) 424-7898  
TBPE F-1640

SUGARCANE RD  
**UTILITY & DRAINAGE LAYOUT**

STA 20+00.00 TO STA 30+00.00

SCALE : 1"=50' SHEET 2 OF 3

FED. RD. DIV. NO.	FEDERAL AID PROJECT NO.	SHEET NO.
		45
STATE	DIST.	COUNTY
TEXAS		HIDALGO
CONT.	SECT.	JOB
		HIGHWAY NO.
		SUGAR CANE DR.